

APPLICATION FOR PERMIT SEWER—SEWAGE DISPOSAL

1

COUNTY OF LOS ANGELES
DEPARTMENT OF COUNTY ENGINEER
BUILDING AND SAFETY DIVISION
JOHN A. LAMBIE, County Engineer
WILLIAM A. JENSEN, Sup't of Building

FOR APPLICANT TO FILL IN

LEGAL DESCRIPTION LOT NO. 22
BLOCK 30 TRACT H T HAZARDS
SIZE OF LOT 53 X 110 NO. OF BLDGS. NOW ON LOT 2
USE OF BUILDINGS Res & Gar
CONTRACTOR ARCO PLUMBING
ADDRESS 527 W. Laverne Blvd
CITY Inglewood PK TEL. NO. AT 4-439
REGISTRATION NO. 13206-C-36 STATE COUNTY

NO.	DESCRIPTION OF WORK	FEE
	HOUSE SEWER CONNECTING TO PUBLIC SEWER @ \$3.00	
	SEPTIC TANK, SEEPAGE PIT OR PITS AND/OR DRAINFIELD @ \$3.00	
	OVERFLOW SEEPAGE PIT, DRAINFIELD EXTN., CESSPOOL, DRYWELL @ \$2.00	
	HOUSE SEWER CONNECTING TO PRIVATE DISPOSAL SYSTEM @ \$1.00	
	CONNECT ADDITIONAL BLDG. OR WORK TO HOUSE SEWER @ \$1.00	
1	ALTER, REPAIR OR ABANDON HOUSE SEWER OR DISPOSAL SYSTEM @ \$1.00	1.00

OWNER'S PERMIT \$ 2 00
AUTHORIZATION TOTAL FEE 3 00

I HAVE AT THIS DATE A CONTRACT WITH THE HEREIN NAMED CONTRACTOR TO CONNECT THE ABOVE DESCRIBED EXISTING DWELLING TO THE PUBLIC SEWER.

SIGNED THIS 22 DAY OF Dec 1940

OWNER OR OWNERS AGENT Arco Plumbing

ADDRESS 527 W. Laverne Blvd

I HEREBY ACKNOWLEDGE THAT I HAVE READ THIS APPLICATION AND STATE THAT THE ABOVE IS CORRECT AND AGREE TO COMPLY WITH ALL COUNTY ORDINANCES AND STATE LAWS REGULATING PLUMBING AND SEWERS.

I HEREBY CERTIFY THAT I AM PROPERLY REGISTERED AND/OR LICENSED AS REQUIRED BY LOS ANGELES COUNTY AND STATE OF CALIFORNIA OR THAT I AM THE LEGAL OWNER OF THE ABOVE DESCRIBED RESIDENTIAL PROPERTY.

SIGNATURE OF PERMITTEE Jack L. Bell

BUILDING ADDRESS 3675 E 3rd St
LOCALITY S. L. A
NEAREST CROSS ST. Hick
OWNER RUDMITKIN
MAIL ADDRESS
CITY TEL. NO.

DISTRICT NO. 6 GROUP I BK MAP PG 154 PROCESSED BY Jeffers
CONNECTION DATA

STATION 10+64.8 DEPTH
MANHOLE REFERENCE Permit 19275 UPPER LOWER

Y. TYPE OF CONNECTION CURB P.L. LENGTH FROM M.L. TO P.L.

CO. IMP. NO. P. C. NO. 11537
JOB NO.

TRUNK PERMIT NO. ROAD PERMIT NO.

STATE ENCROACHMENT PERMIT NO.

INDUSTRIAL WASTE APPROVAL

CHARGES

CONNECTION CHARGE FEE

REIMBURSEMENT FEE

APPROVALS	DATE	INSPECTOR'S SIGNATURE
NEW HOUSE SEWER		
CONNECT ADDITIONAL BUILDING OR WORK		
SEPTIC TANK, SEEP. PIT(S) AND/OR DRAINFIELD		
CESSPOOL <input type="checkbox"/> DRYWELL <input type="checkbox"/>		
ALTER, REPAIR, SEWER OR SEWAGE DISPOSAL SYSTEM	12-28-60	Conrad
DISCONNECT PLUG AND ABANDON HOUSE SEWER		
BACKFILL SEPTIC TANKS <input type="checkbox"/>		
SEEP. PIT(S) <input type="checkbox"/> CESSPOOLS <input type="checkbox"/>		

VALIDATION

CK

M. O.

CASH

ROBERT A. WOOD
SUPERVISING MECHANICAL ENGINEER

AC 57078 DEC 22 1940

3.00


Jeffers

INSPECTOR COPY

FOR DEPARTMENT USE

REQUIRED INFORMATION

1. INDICATE ALL BUILDINGS ON PROPERTY.
2. INDICATE AND DIMENSION SEWAGE DISPOSAL SYSTEM WITH TIE DISTANCES TO BUILDINGS AND PROPERTY LINES.
3. INDICATE SIZE OF SEPTIC TANK—DEPTH OF SEEPAGE PIT(S)—SIZE OF CESSPOOL(S).
4. INDICATE NORTH DIRECTION ON PLOT.
5. INDICATE BOTH STREETS IF CORNER.

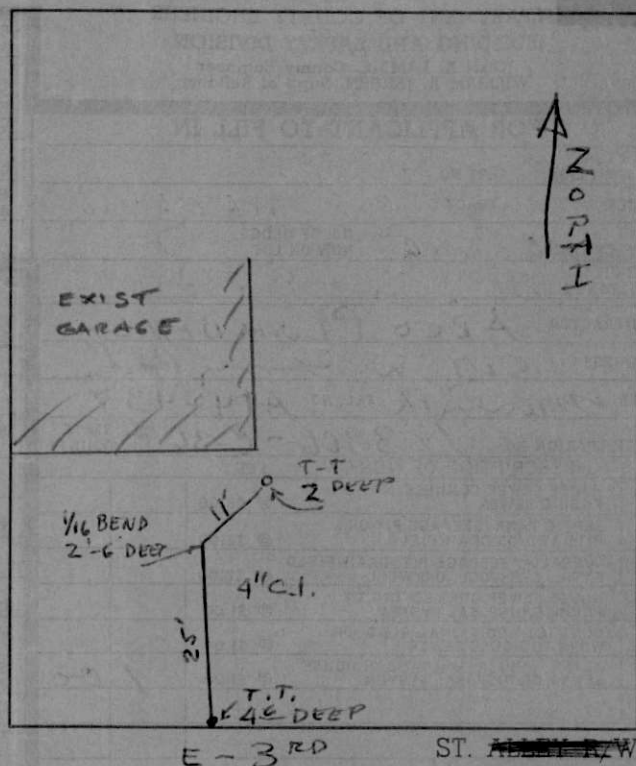

FIELD NOTES